

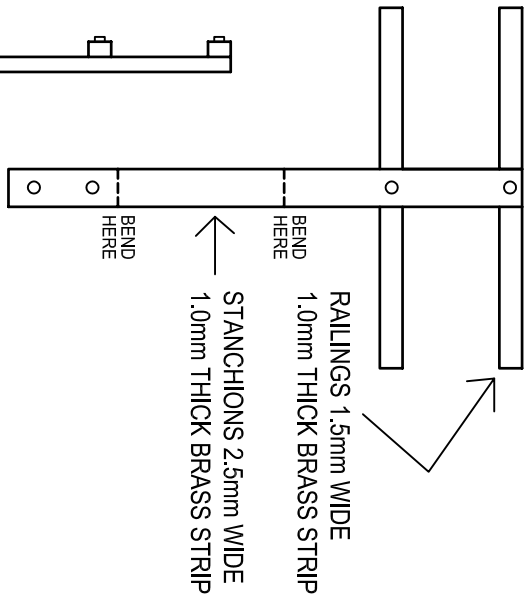


OPEN HUNGRY BOARDS

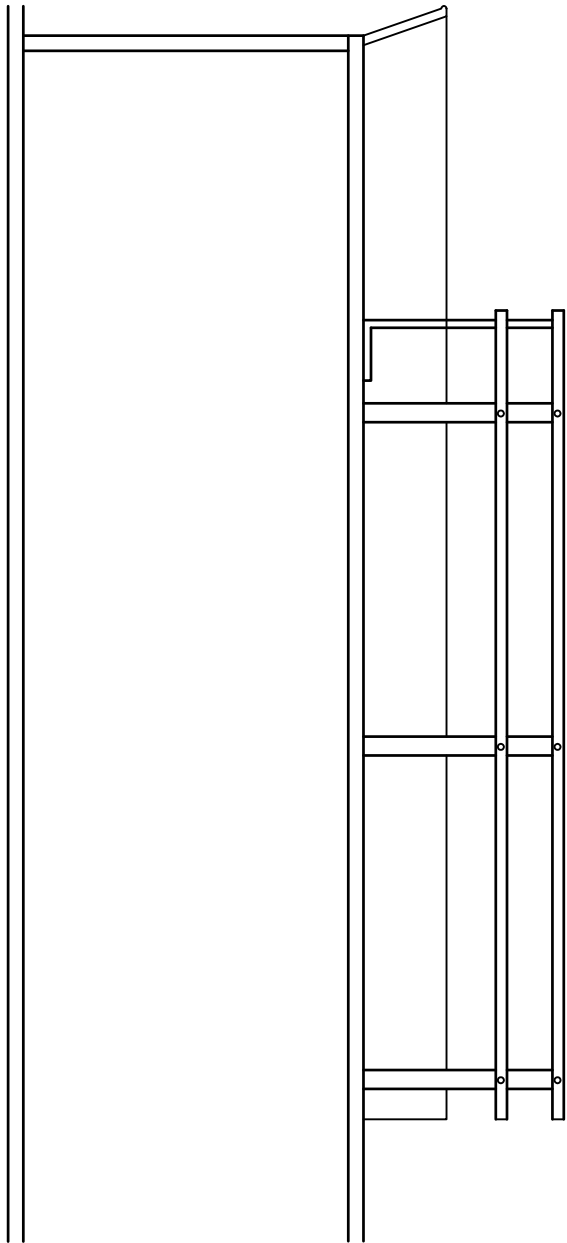

TYPICAL STANCHION  
SCALE 2:1

3NO. STANCHIONS TO REAR OF HUNGRY BOARDS

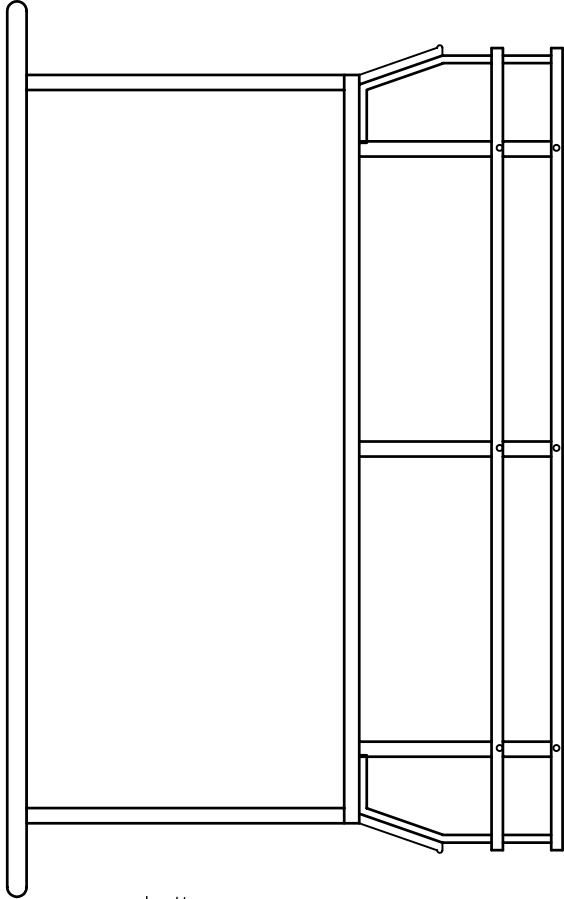

HUNGRY BOARDS  
AS BUILT – LONG TENDER  
SECTIONAL VIEW

