


TENDER SIDES



# BULLY BOY

OVERALL TENDER VIEW  
AS BUILT – BULLY BOY

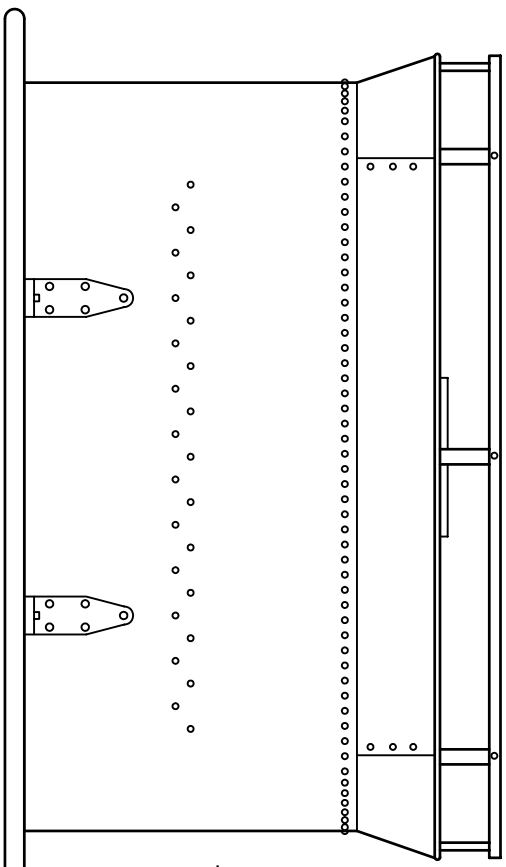